


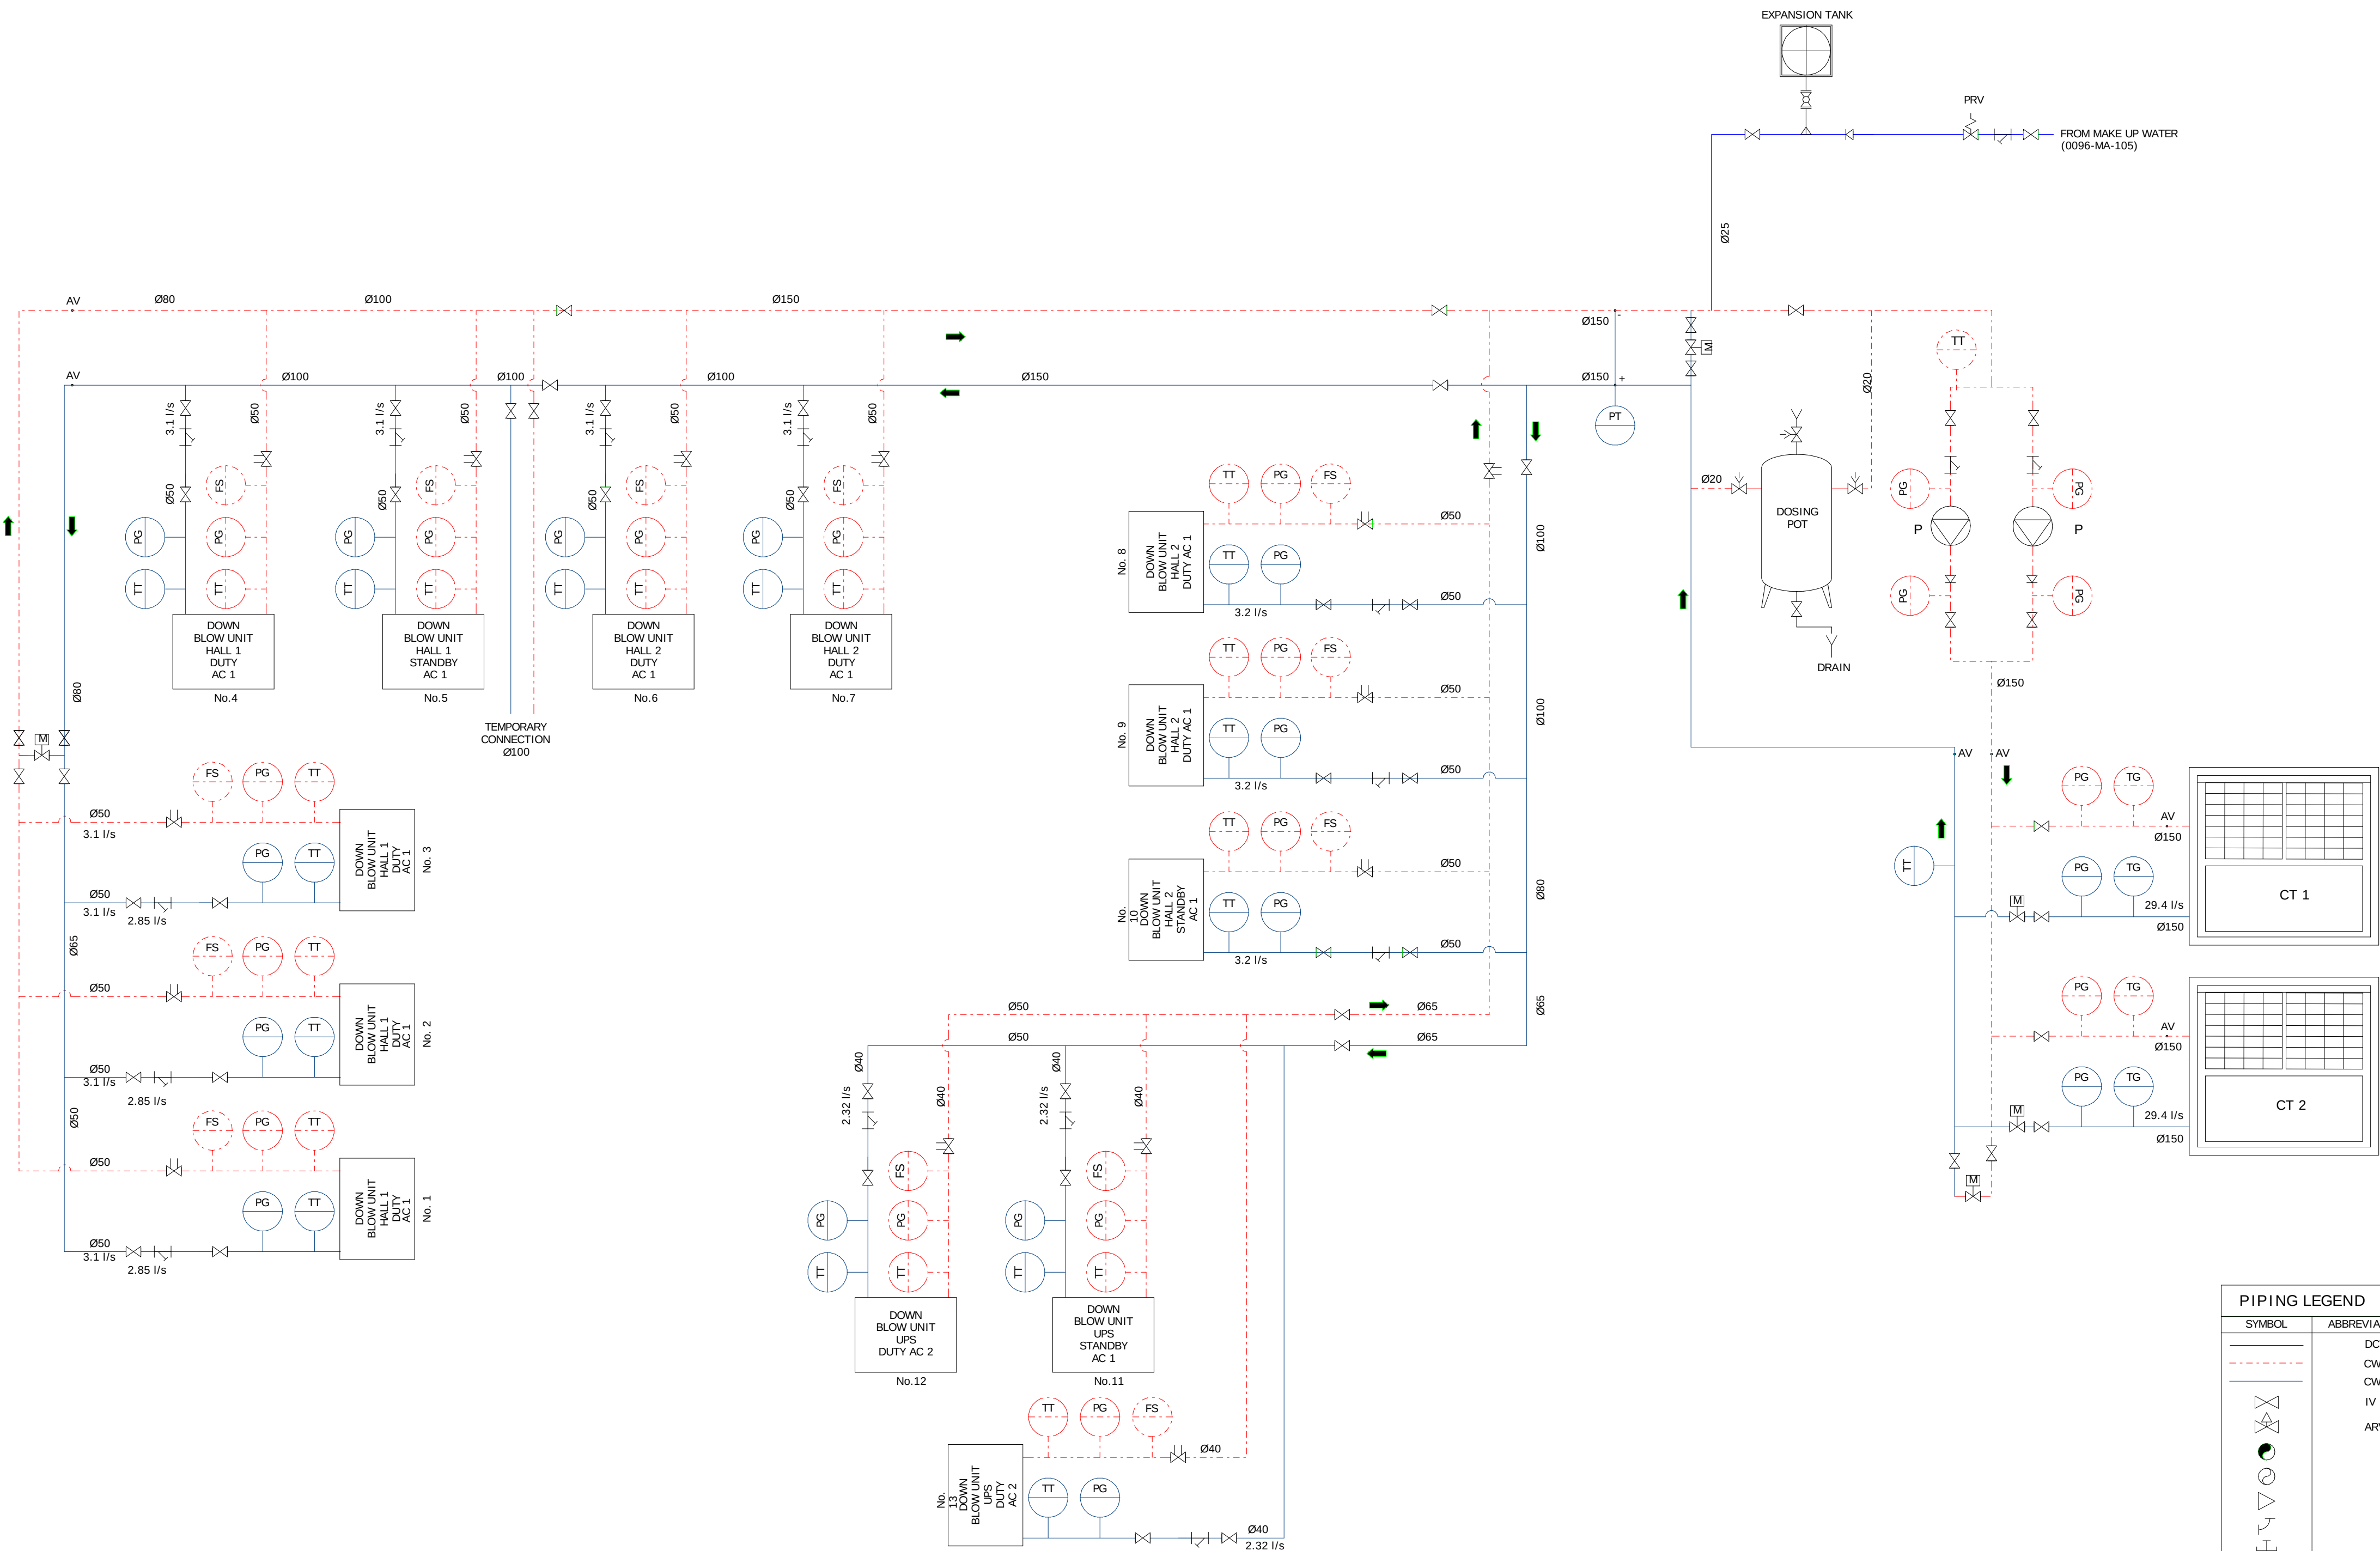

CONDENSER WATER SCHEMATIC
1 : 100

PIPING LEGEND		
SYMBOL	ABBREVIATION	DESCRIPTION
	DCW	- COLD WATER SUPPLY PIPING
	CWR	- CONDENSER WATER RETURN
	CWS	- CONDENSER WATER SUPPLY
	IV	- ISOLATION/STOP VALVE
	ARV	- AIR RELEASE VALVE
		- PIPE RISER/PIPE CUT
		- PIPE DROPPER
		- REDUCER
		- ELBOW
		- TEE
		- REDUCING TEE
	PRV	- PRESSURE RELIEF VALVE
	S	- STRAINER
	M	- WATER METER
	NRV	- NON RETURN VALVE
	MBV	- MOTORIZED BALANCING VALVE
		- AUTOMATIC BLEED VALVE
	VB	- VACUUM BREAKER
	ARV	- AIR RELEASE VALVE
		- FLOW DIRECTION
		- HOT WATER TANK / VESSEL
	HP	- HEAT PUMP
	P	- CIRCULATION PUMP
	BV	- BALANCING VALVE
	re	- RODDING EYE
	ie	- INSPECTION EYE
	oe	- CLEANING EYE
	vp	- VENT LINE
	st	- STACK
	dr	- DRAIN
	fd	- FLOOR DRAIN
	fbo	- FULL BORE OUTLET
	prep	- PREP BOWL

AS BUILT DRAWING

- NOTES:
- FOR GENERAL NOTES REFER TO DRAWING
 - DRAWINGS ARE NOT TO BE SCALED. ALL LEVELS AND DIMENSIONS TO BE VERIFIED ON SITE PRIOR TO COMMENCEMENT OF WORKS. ANY DISCREPANCIES TO BE BROUGHT TO THE ENGINEERS ATTENTION IMMEDIATELY
 - THIS DRAWING IS TO BE READ IN CONJUNCTION WITH ALL OTHER DRAWINGS, SCHEDULES AND SPECIFICATIONS RELATED TO THIS PROJECT.
 - ALL BUILDING WORK AND MATERIALS ARE TO COMPLY WITH LOCAL AUTHORITY'S REQUIREMENTS AND ARE TO BE IN ACCORDANCE WITH SANS 10400 NATIONAL BUILDING REGULATIONS

NO	DATE	DESCRIPTION	DRN BY

CONSULTING ENGINEER SIGNATURE: _____ DATE: _____
PROFESSIONAL REG.:

CLIENT SIGNATURE: _____ DATE: _____

CLIENT NAME:



CONSULTANTS DETAILS:



Royal HaskoningDHV
Enhancing Society Together

Fountain Square
78 Kalkoen Street
Mounment Park
Pretoria
Tel No. (087) 352-1500

HVAC CONTRACTORS DETAILS:



Action
REFRIGERATION
AIRCONDITIONING

27 Clough Street
Pietermaritzburg
KwaZulu Natal
+27 33 345 3135
admin@actionair.co.za

SERVICE:
MECHANICAL HVAC

PROJECT NAME:
SITA DATA & SWITCHING CENTRE

SHEET TITLE:
**CONDENSER WATER
RETICULATION SCHEMATIC**

DATE: 2021-04-05	ACTION REF NO: 0096
PAPER SIZE: A1	DESIGNED BY: ROYAL HASKONING DHV
SCALE: 1 : 100	DRAWN BY: P. M. CHAMBERS
	CHECKED BY: M. NUGENT

DRAWING NUMBER: **0096-MA-104** REV: _____